




AS CONSTRUCTED - SEWER

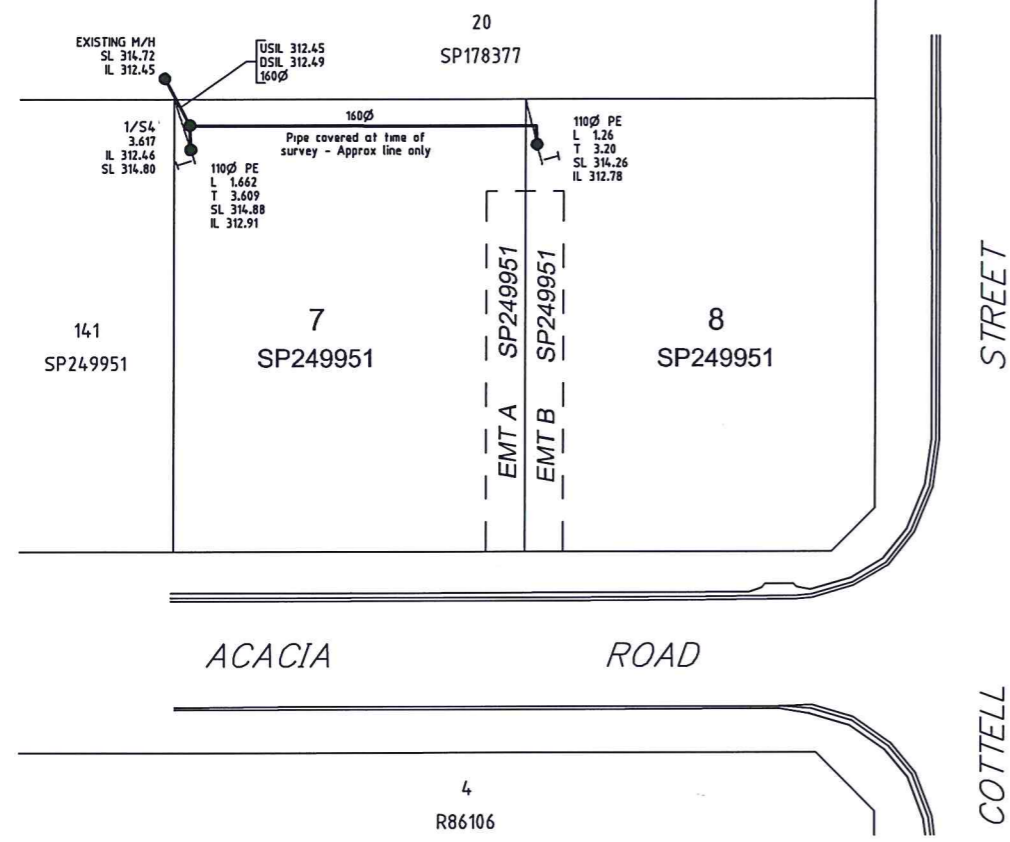


AS CONSTRUCTED - STORMWATER

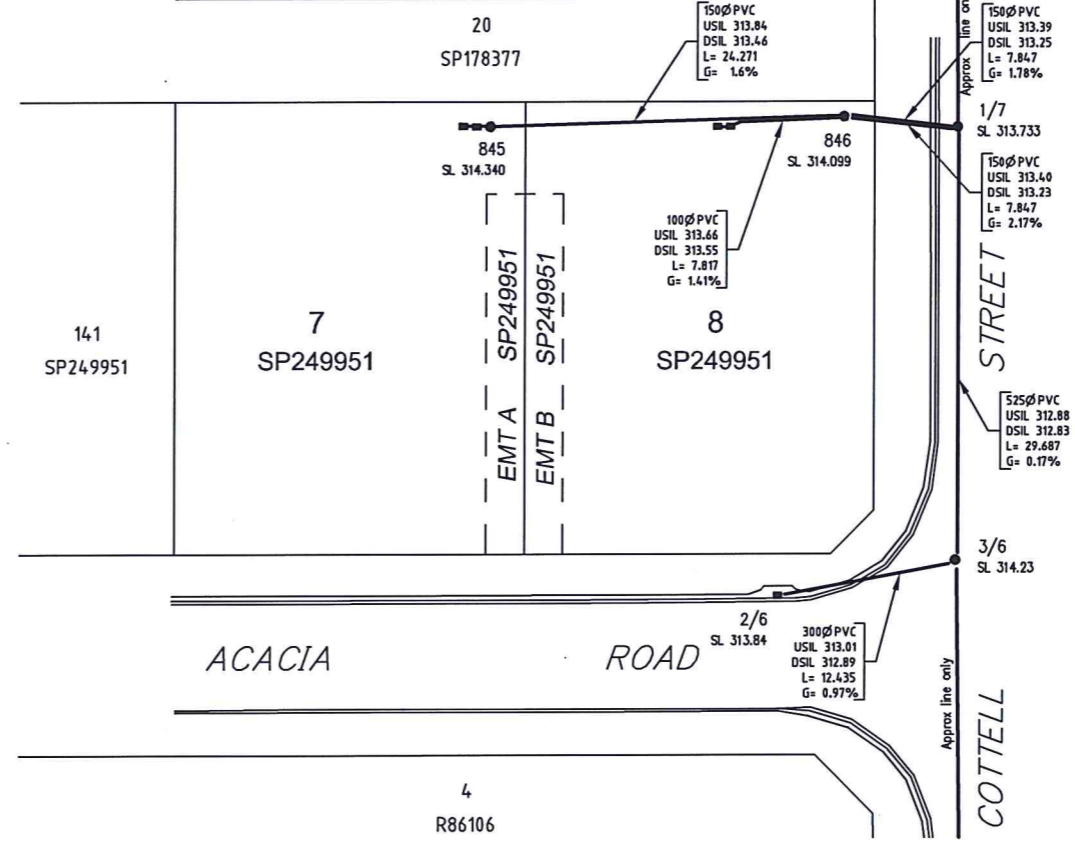


AS CONSTRUCTED - CONTOURS

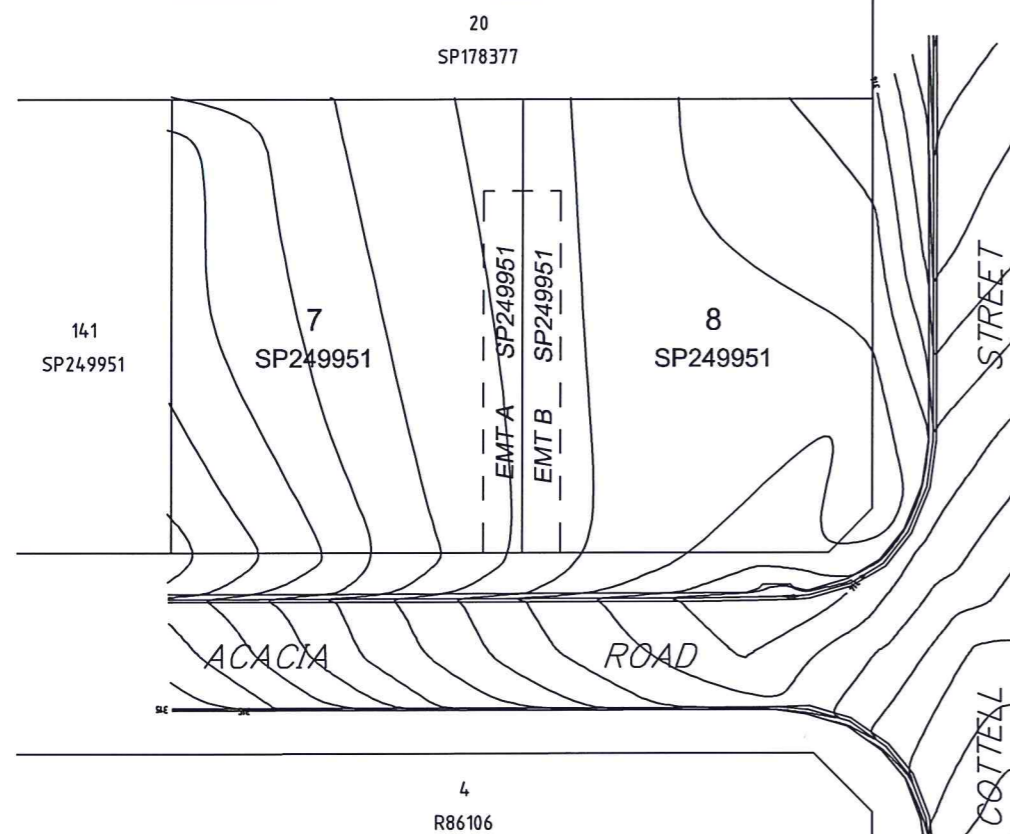

AS CONSTRUCTED - WATER AND GAS

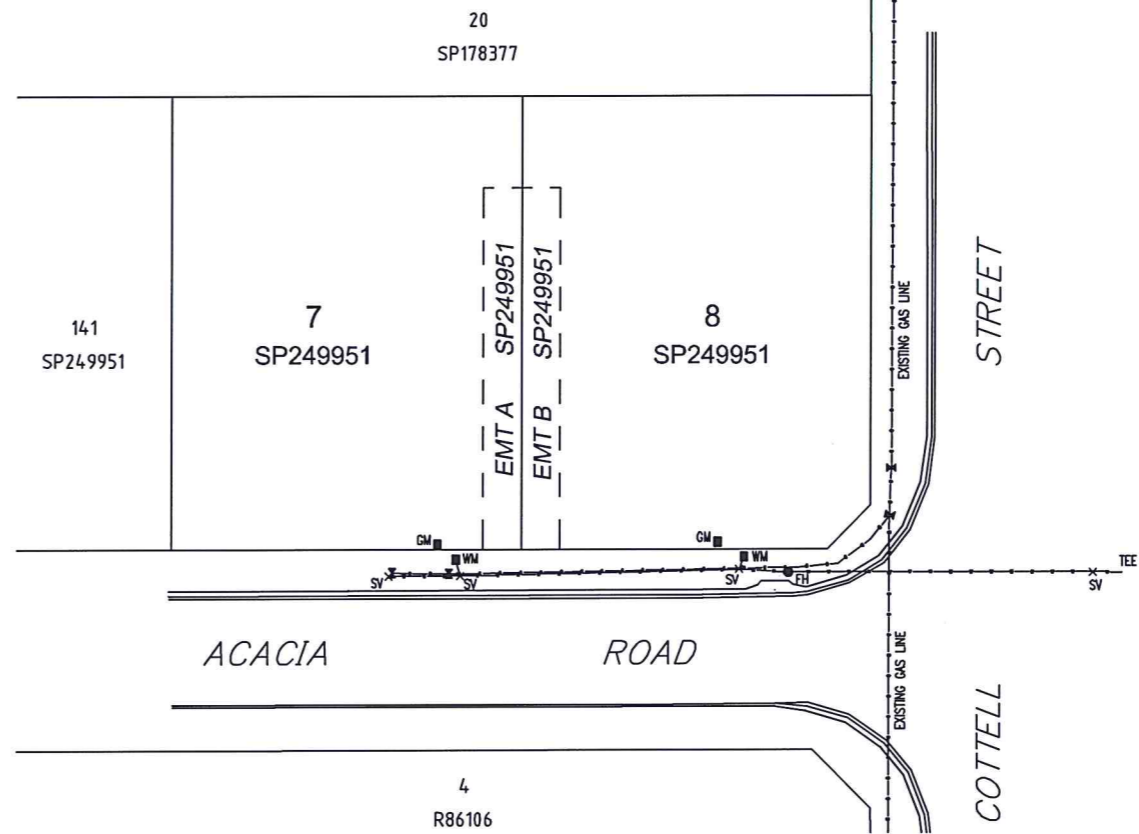

**WORKS AS CONSTRUCTED**  
 It is certified that the original drawings have been carefully compared with the works As Constructed as to line, level and dimensions and it has been accurately amended as required so as to constitute a true and correct record of the works As Constructed.  
 Signature: *[Signature]* Date: 6/3/14  
 Name of Signatory: Jason M. M. M. M.  
 RPEQ No. 6336  
 BRADFORD LEES PTY LTD

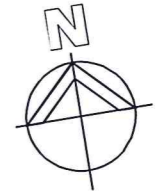

LEGEND	
	GAS - Ø0.100
	WATER - Ø0.150
	FH FIRE HYDRANT
	WM WATER METER
	GM GAS METER
	V VALVE

ISSUE	DATE	AUTHOR	COMMENTS
A	29/11/2013	AL	FINAL

**Works As Constructed**  
 Fyfe Pty Ltd (A.B.N. 57 008 116 130) hereby certifies that the Company has surveyed the position and level of the services shown on this plan and that the "as constructed" information is accurate.  
 Surveyor: *[Signature]*  
 Date: 17-02-2014

**FYFE PTY LTD**  
 56 BUNGIL STREET  
 ROMA QLD 4455  
 PO BOX 79  
 ROMA QLD 4455  
 TELEPHONE 61 7 4622 2777  
 FACSIMILE 61 7 4622 7766  
 info@fyfe.com.au  
 www.fyfe.com.au

**J K CIVIL CONTRACTING PTY LTD**  
 PROJECT: CLEARVIEW RISE - LOTS 7 & 8 AS CONSTRUCTED

ASSOCIATE CONSULTANT: BRADLEES CIVIL CONSULTING  
 LOCAL GOVERNMENT: MARANOA REGIONAL COUNCIL  
 SCALE: 1:250 (at A1) - Lengths are in Metres.

DATUM		AHDD	
LEVEL ORIGIN	PSM 181325	RL	321.423m
CONTOUR INTERVAL	0.2m		
FILE REFERENCE	37748-18-1		
DRAWN	AL	DATE	29/11/2013
CHECKED	JDM	DATE	29/11/2013
APPROVED	JDM	DATE	29/11/2013
PLAN NUMBER	37748_ASCON_LOTS_7&8	SHEET	OF