

A3PPP PROJECT ROMA DA26 39968 STAGE 2 CLEARVIEW RISE ESTATE 3PPP ACQUISITION PROJECT.

- SURVEY REQUIRED

THE INTENT OF THIS PROJECT IS TO INSPECT, NEGOTIATE AND ACQUIRE 3PPP AS PER 018801 - 3RD PARTY PIT & PIPE (3PPP) DESIGNPROCESS - TELSTRA ACQUISITION. CABLE WILL BE BRIEFED VIA A SEPARATE PROJECT.

ADDRESS: COTTELL ST, ROMA QLD 4455
 PBR: 31732588
 AFR: 17322431
 #LOTS: 2
 GPS CO-ORD'S: -26.570879, 148.777176
 DEVELOPER CONTACT DETAILS
 COMPANY: EDQ
 DEVELOPER: GENAEA MITCHELL
 PH: 731740205
 ADDRESS: PO BOX 2202, BRISBANE 4001
 APPLICANT CONTACT DETAILS
 COMPANY: SPA CONSULTING ENGINEERS
 APPLICANT: IAN WOODCOCK
 PH: 740323311
 ADDRESS: PO BOX 664 NTH CAIRNS 4870.

CONSTRUCTION COPY			
ITEM	DESCRIPTION	QTY	ACTUAL
HN-1e1	TRAVEL TO SITE FOR INSPECTION OF 3PPP	1.0	
HN-1e2	INSPECTION OF 3PPP LOTS	2.0	

PROJECT LEGEND	
	CONSTRUCTED 3PPP
	CONSTRUCTED TELSTRA PIPE
	EXISTING TELSTRA PIPE
	LEFT INSITU OR RECOVER
	OTHER PROJECT PIPE
	CPR UPDATE
	JOINT USE POLE
	POWER AUTHORITY POLE
	TELSTRA POLE
	PROPOSED 3PPP
	PROPOSED TELSTRA PIPE
	PROPOSED TELSTRA PIT
	CONSTRUCTED TELSTRA PIT
	OTHER PROJECT TELSTRA PIT
	EXISTING TELSTRA PIT
	POWER CO-ORDINATION HAZARD AREA
	TELSTRA SCHEDULE B CODES

***** ATTENTION CONSTRUCTORS *****
FOR COMPLIANCE PURPOSES
 DO NOT CHANGE THE WORK SPECIFICATIONS OF THIS PROJECT WITHOUT FIRST CHECKING WITH THE DESIGNER.

NOTE: IF ACTUAL WORK DONE DIFFERS FROM THE ORIGINAL DESIGNED WORK THE PERSON PERFORMING THE WORK MUST AMEND THIS COPY OF THE PLAN ACCORDINGLY.

DANGER
 BEFORE EXCAVATING CHECK FOR POWER CABLES AND GAS PIPES, ENSURE THAT YOU HAVE CALLED "1100 DIAL BEFORE YOU DIG" FOR ALL SERVICES LOCATIONS



WARNING
 THIS PLAN CONTAINS COMMERCIALY SENSITIVE INFORMATION AND IS TO BE TREATED ACCORDINGLY NO SUCH INFORMATION IS TO BE PASSED ON TO OTHER PARTIES WITHOUT THE WRITTEN CONSENT OF THE TELSTRA CORPORATION.




NOTE: UNLESS NOTED OTHERWISE
 1. DISTANCES ARE ALL SURFACE MEASUREMENTS IN METRES.
 2. ALL CONDUCTORS 0.40 DIAMETER AND SHEATH TYPE PE.
 3. PIT CONSTRUCTION TYPE - P.
 4. ALL PLANT TO BE INSTALLED TO CURRENT TELSTRA STANDARD DEPTH.
 5. ALL ALIGNMENTS TO EXISTING UTILITY AND LOCAL GOVERNMENT AGREEMENTS.

OFFICE COPY

PROJECT TYPE: A3PPP	TELSTRA REF: 95550656
ISGM ID: 95550656	WORK ORDER:
DRAWING NUMBER: 95550656 ROMA REV A	SHEET 001 OF 001
ADDRESS: CLEARVIEW RISE STG2 COTTELL ST ROMA, QLD, 4455	

NAME	DATE	NAME	DATE
INSPECTOR		DRAWN	D.C.Sheehan 17-12-13
DESIGNER	D.C.Sheehan 17-12-13	DESIGN APPROVED	J.KOGAN 19/12/2013
REV	DESCRIPTION	DESIGN	DES DATE
A	D.C.Sheehan	DCS	17-12-13
		APPR	QA DATE
		NLB	17-12-13

CABINET:	CABLE: 0201-300	PILLAR: P26	CLP: N
EXCHANGE CODE: ROMA	DA NUMBER: 26	REGION: PI03	REVISION: A

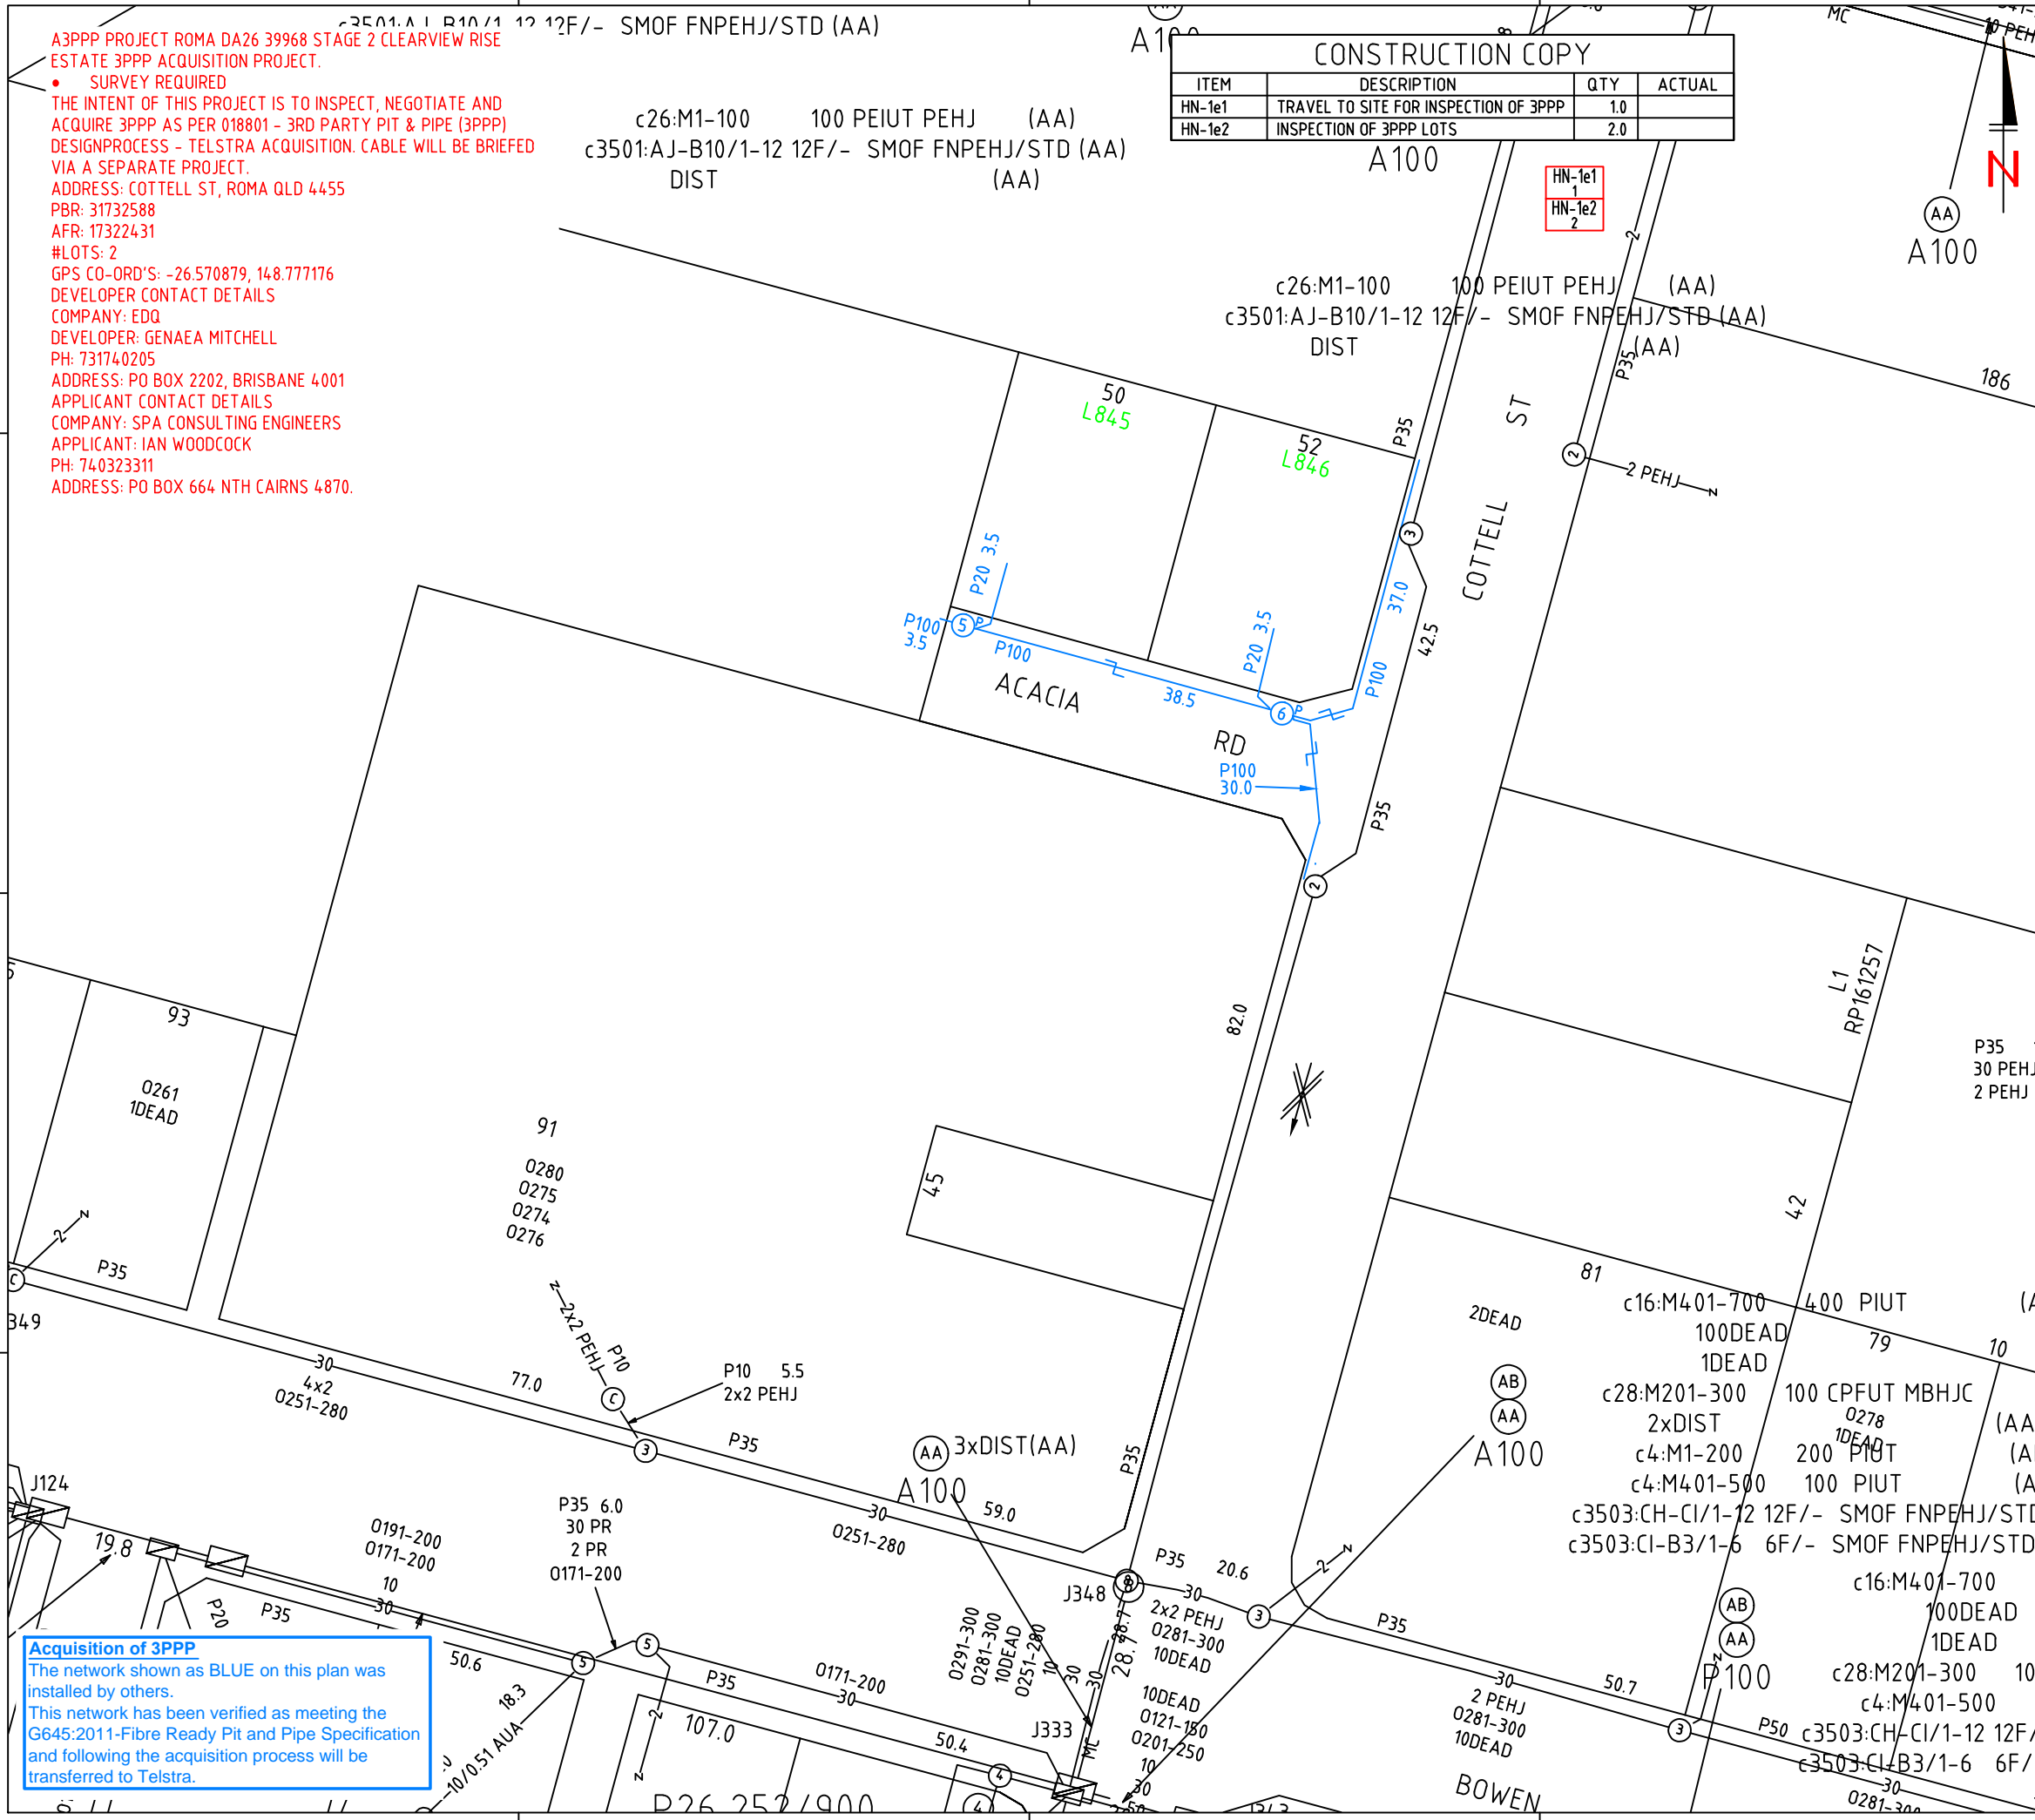

Acquisition of 3PPP
 The network shown as BLUE on this plan was installed by others.
 This network has been verified as meeting the G645:2011-Fibre Ready Pit and Pipe Specification and following the acquisition process will be transferred to Telstra.